HVAC OUTDOOR AIR REQUIREMENTS 1. SHOWROOM = 3224 SQUARE FEET 2. HARD PARTS = 3648 SQUARE FEET

2009 INTERNATIONAL MECHANICAL (IMC) CODE REFERENCES: TABLE 403.3 FOR REQUIRED OUTDOOR VENTILATION AIR IN RETAIL - "SALES/STORAGE ROOM."

SHOWROOM (SALES) $3224 \text{ (sq.ft.)} \div 1000 \text{ (sq.ft.)} = 3.22$ 3.22×15 (persons per/1000 sq.ft.) = 48.36 persons $(CFM/person) \times persons + CFM/sq.ft. \times sq.ft. = CFM$ $7.5 \times 48.36 + .12 \times 3224 = 750$ CFM of outside air

750 / .8 (effectiveness) = 937 CFM HARD PARTS: ("STORAGE ROOM")

 3648×0.12 (CFM/per sq. ft.) = 438 CFM of outside air

438 / .8 (effectiveness) = 547 CFM

937 (CFM) + 547 (CFM) = 1484 CFM

TOTAL OUTSIDE AIR MINIMUM REQUIRED BY CITY: 1484 CFM OUTSIDE AIR SPECIFIED ON PLAN SHEET M1 = 1484 CFM


- DRAWING IS DIAGRAMMATIC AND IS NOT TO BE SCALED. REFER TO ARCHITECTURAL PLANS OR FIELD MEASUREMENTS FOR DIMENSIONS. ALL WORK IS TO BE PERFORMED IN ACCORDANCE WITH THE APPLICABLE CODE(S) NOTED ON THE COVER SHEET. DUCT DIMENSIONS ON PLANS ARE TO BE FINISHED INSIDE
- THE CONTRACTOR SHALL FIELD VERIFY ALL EXISTING CONSTRUCTION PRIOR TO SUBMITTING HIS BID. NO EXTRAS WILL BE PAID DUE TO UNANTICIPATED EXISTING CONDITIONS ALL ROOF AND WALL PENETRATIONS REQUIRED SHALL BE
- COORDINATED WITH THE GENERAL CONTRACTOR. PROVIDE ALL SLEEVES, FLASHING, CURBS, REINFORCING ANGLES, SUPPORTING FRAMES, ETC., WHICH ARE REQUIRED UNLESS THEY ARE SPECIFICALLY CALLED OUT TO BE FURNISHED BY OTHERS. A SUBMITTAL OF ALL MATERIALS AND EQUIPMENT PROPOSED TO BE USED ON THE JOB SHALL BE PREPARED AS SOON AS POSSIBLE
- AFTER AWARD OF THE CONTRACT. THE SUBMITTAL WILL BE REVIEWED BY THE OWNER FOR EQUAL QUALITY AND PERFORMANCE TO THE ITEMS SPECIFIED. ALL CONTROL DEVICES SHALL BE INCLUDED IN THE SUBMITTAL.


PROJECT.COORDINATION DOES NOT MEAN "I WAS HERE FIRST"


THE PROPER PERFORMANCE OF THE CONTROL SYSTEM IS THE RESPONSIBILITY OF THE CONTRACTOR. THE CONTRACTOR SHALL COOPERATE AND COORDINATE HIS WORK WITH THE WORK OF OTHER SUBCONTRACTORS OF THE

HVAC GENERAL NOTES


- THE CONTRACTOR SHALL BE RESPONSIBLE FOR INSTALLING A COMPLETE AND FUNCTIONAL SYSTEM IN ACCORDANCE WITH THE INTENT OF THE PLANS, WHETHER OR NOT EVERY ELEMENT THEREOF IS SPECIFICALLY CALLED OUT.
- 10. DUCT MATERIALS SHALL BE AS FOLLOWS: ROUND SUPPLY AIR DUCT (SPEC 23 30 00) RECTANGULAR SUPPLY AND RETURN AIR DUCT WORK (SPEC 23 30 00) INSTALL TURNING VANES IN ALL ELBOWS. DO NOT SUBSTITUTE RADIUSED ELBOWS. RUNOUTS TO DIFFUSERS - (SPEC 23 30 00) (SEE DIFFUSER INSTALLATION DETAIL).
- EXHAUST DUCT (SPEC 23 30 00) TRANSITIONS - SHALL CONFORM TO SMACNA STANDARDS. . INSULATE HVAC CONDENSATE DRAIN PIPING WITH 1/2" ARMAFLEX.
- 12. ALL WORK IS TO BE GUARANTEED FOR ONE YEAR UPON OCCUPANCY.
- 13. NO EQUIPMENT OR FIXTURE SUBSTITUTIONS (THAT ARE NOT CURRENTLY LISTED) WITHOUT PRIOR WRITTEN APPROVAL OF THE 14. UPON COMPLETION BALANCE SYSTEMS TO AIR FLOWS SHOWN. REPORT THE BALANCING MEASUREMENTS ON THE "AS BUILT"
- 15. MOUNT CONDENSATE AND REFRIGERANT LINES AS HIGH AS POSSIBLE. 16. CONTROL WIRING BY HVAC CONTRACTOR, FINAL CONNECTIONS BY
- HVAC CONTRACTOR. 17. ALL CAULKING ON BUILDING PENETRATIONS SHALL BE A ONE-COMPONENT NON-SAG URETHANE ELASTOMERIC SEALANT. ANY CONTRACTOR WHO USED SILICONE OR ANY OTHER CAULKING WILL BE REQUIRED TO REMOVE AND REPLACE WITH A SPECIFIED
- SEALANT (SPEC: 07 92 00). 18. THE HVAC SYSTEM SHALL BE CONSTRUCTED IN ACCORDANCE WITH NFPA 101:7-2 and NFPA 90A "STANDARD FOR THE INSTALLATION OF AIR CONDITIONING AND VENTILATION SYSTEMS".
- 19. ALL HVAC SYSTEM FLUES & VENTS SHALL BE CONSTRUCTED IN ACCORDANCE WITH NFPA 54 (LATEST EDITION). 20. PROVIDE AIR FILTRATION MEDIÀ FOR OUTSIDE AND RETURN AIR PRIOR TO OCCUPANCY THAT PROVIDES AT LEAST A MINIMUM.
- EFFICIENCY REPORTING VALUE (MERV) OF 8. 21. COVERING OF DUCT OPENINGS AND PROTECTION OF MECHANICAL EQUIPMENT DURING CONSTRUCTION. AT THE TIME OF ROUGH I NSTALLATION, OR DURING STORAGE ON THE CONSTRUCTION SITE AND UNTIL FINAL STARTUP OF THE HEATING AND COOLING EQUIPMENT, ALL DUCT AND OTHER RELATED AIR DISTRIBUTION COMPONENT OPENINGS SHALL BE COVERED WITH TAPE, PLASTIC, SHEETMETAL OR OTHER METHODS ACCEPTABLE TO THE ENFORCING AGENCY TO REDUCE THE AMOUNT OF DUST OR

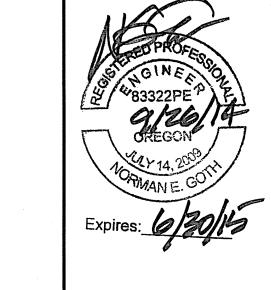


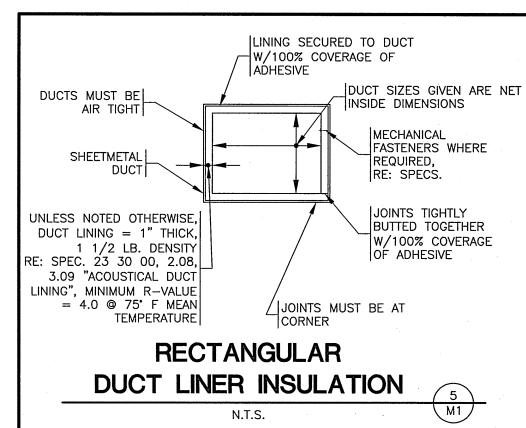

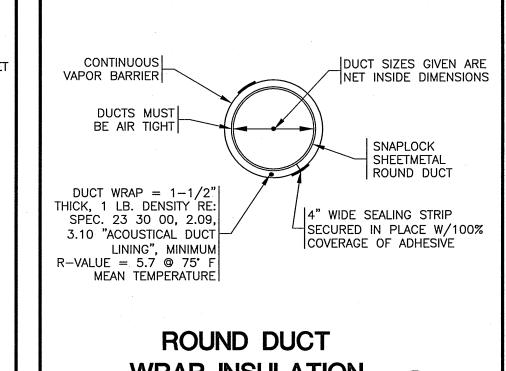


WRAP INSULATION

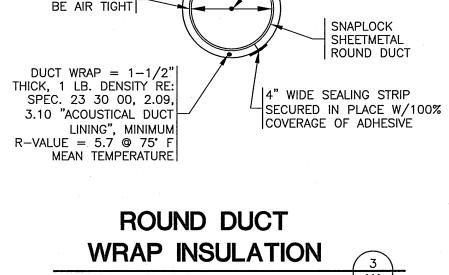


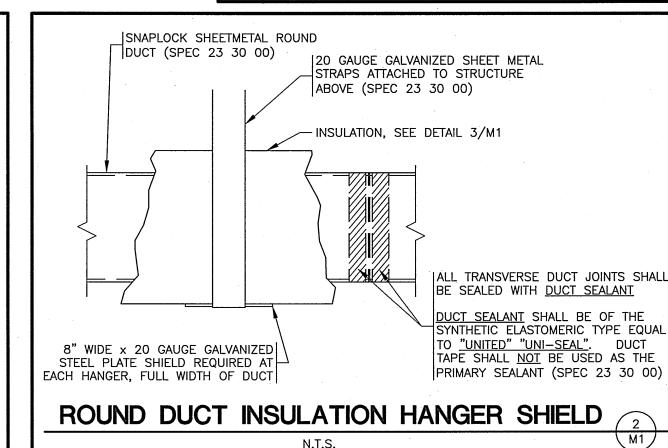

HVAC - KEYNOTES THERMOSTATS. (TYPICAL WIRING FOR EACH THERMOSTAT)


- SEE VS1 SHEET (2) TAPERED CONCENTRIC FITTING, TYPICAL.
- (3) CONDENSATE DRAIN, REFER TO DETAIL 1/M1.
- (4) 12"x12" DUCT W/ ELBOW FROM "R2" TO JUST ABOVE THE CEILING PLATFORM.
- $\langle 5 \rangle$ WALL CAP (MOUNT BOTTOM AT 10'-0" A.F.F.) 500 CFM
- $\langle 6 \rangle$ see partial roof plan above for continuation. Typ.
- (7) CONCENTRIC WALL INTAKE/EXHUAST VENT. REFER TO DETAIL 6/M2, TYP.
- (8) INTERLOCK EACH MOTORIZED DAMPER'S OPERATION WITH THE RESPECTIVE ECONOMIZER AT EACH FURNACE. REFER TO SCHEDULES AND DETAILS ON SHEET 1/M2 FOR MORE INFO. (TYPICAL).
- 9) WIRE FROM NEAREST LIGHT FIXTURE. DAMPER TO BE IN OPEN POSITION WHEN LIGHT IS ON OR IF ECONOMIZER IS OPERATING, TYPICAL.
- $\langle 10 \rangle$ 30" LENGTH OF 24" x 24" DUCT. OPEN ENDED.

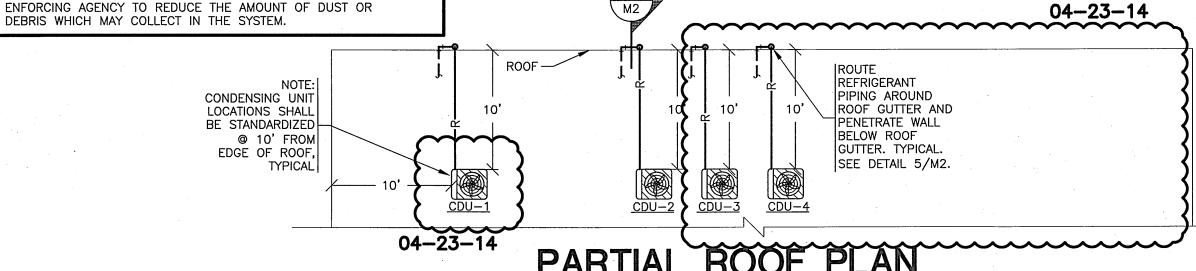

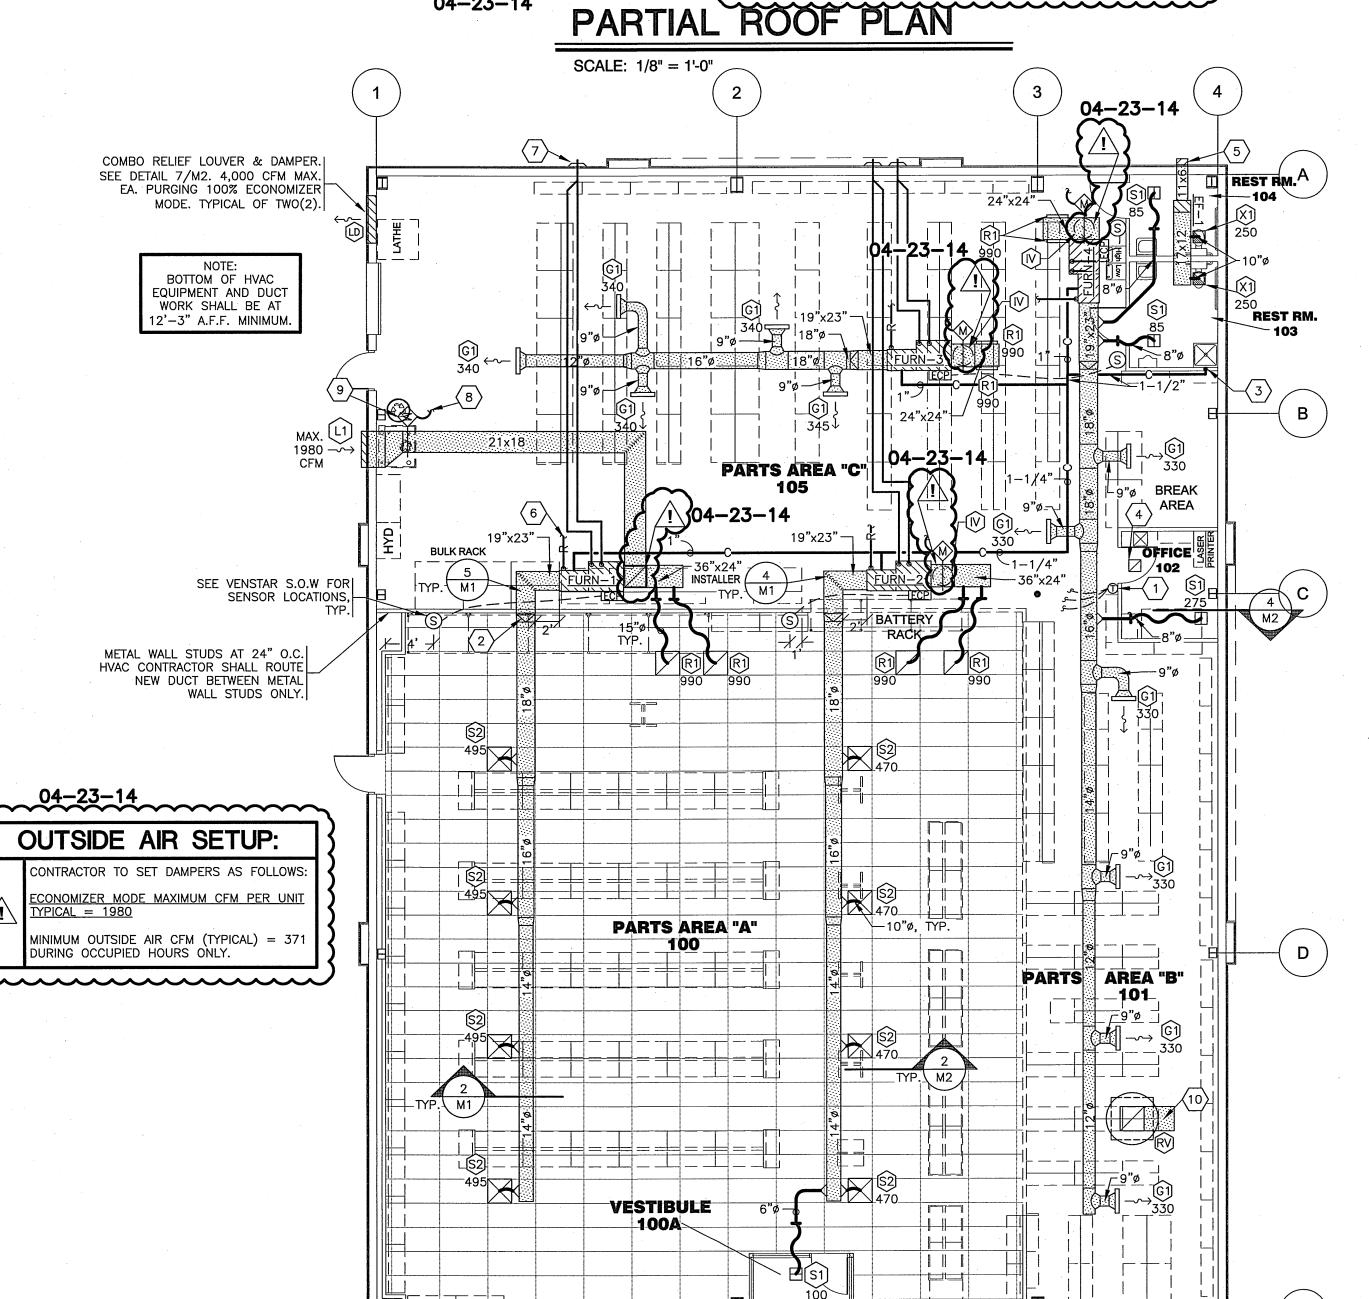


SINGLE THICKNESS VANES UP TO 16" LONG DOUBLE THICKNESS VANES SHEETMETAL OVER 16" LONG WHERE REQUIRED FLOW SQUARE OR RECTANGULAR **TURNING VANES** N.T.S.

N.T.S.

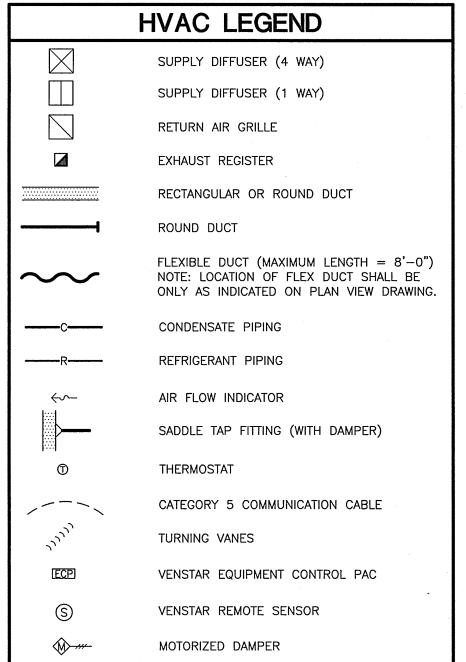

VENSTAR "SCOPE OF WORK" DOCUMENT

S.O.W.

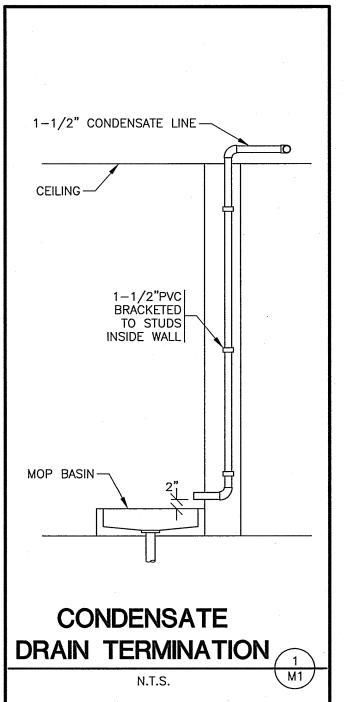

HVAC PLAN

SCALE: 1/8" = 1'-0"



TOD AND € Report Constant MEDICAL PROPERTY. IVY STREET JUNCTION CITY,

4

controllingua su, sociation consumeration temporares coloreste feet proprieta sur²

anderstein generations generations generations

COMM # 3484

04-23-14 REVISION

04-23-14